


2018

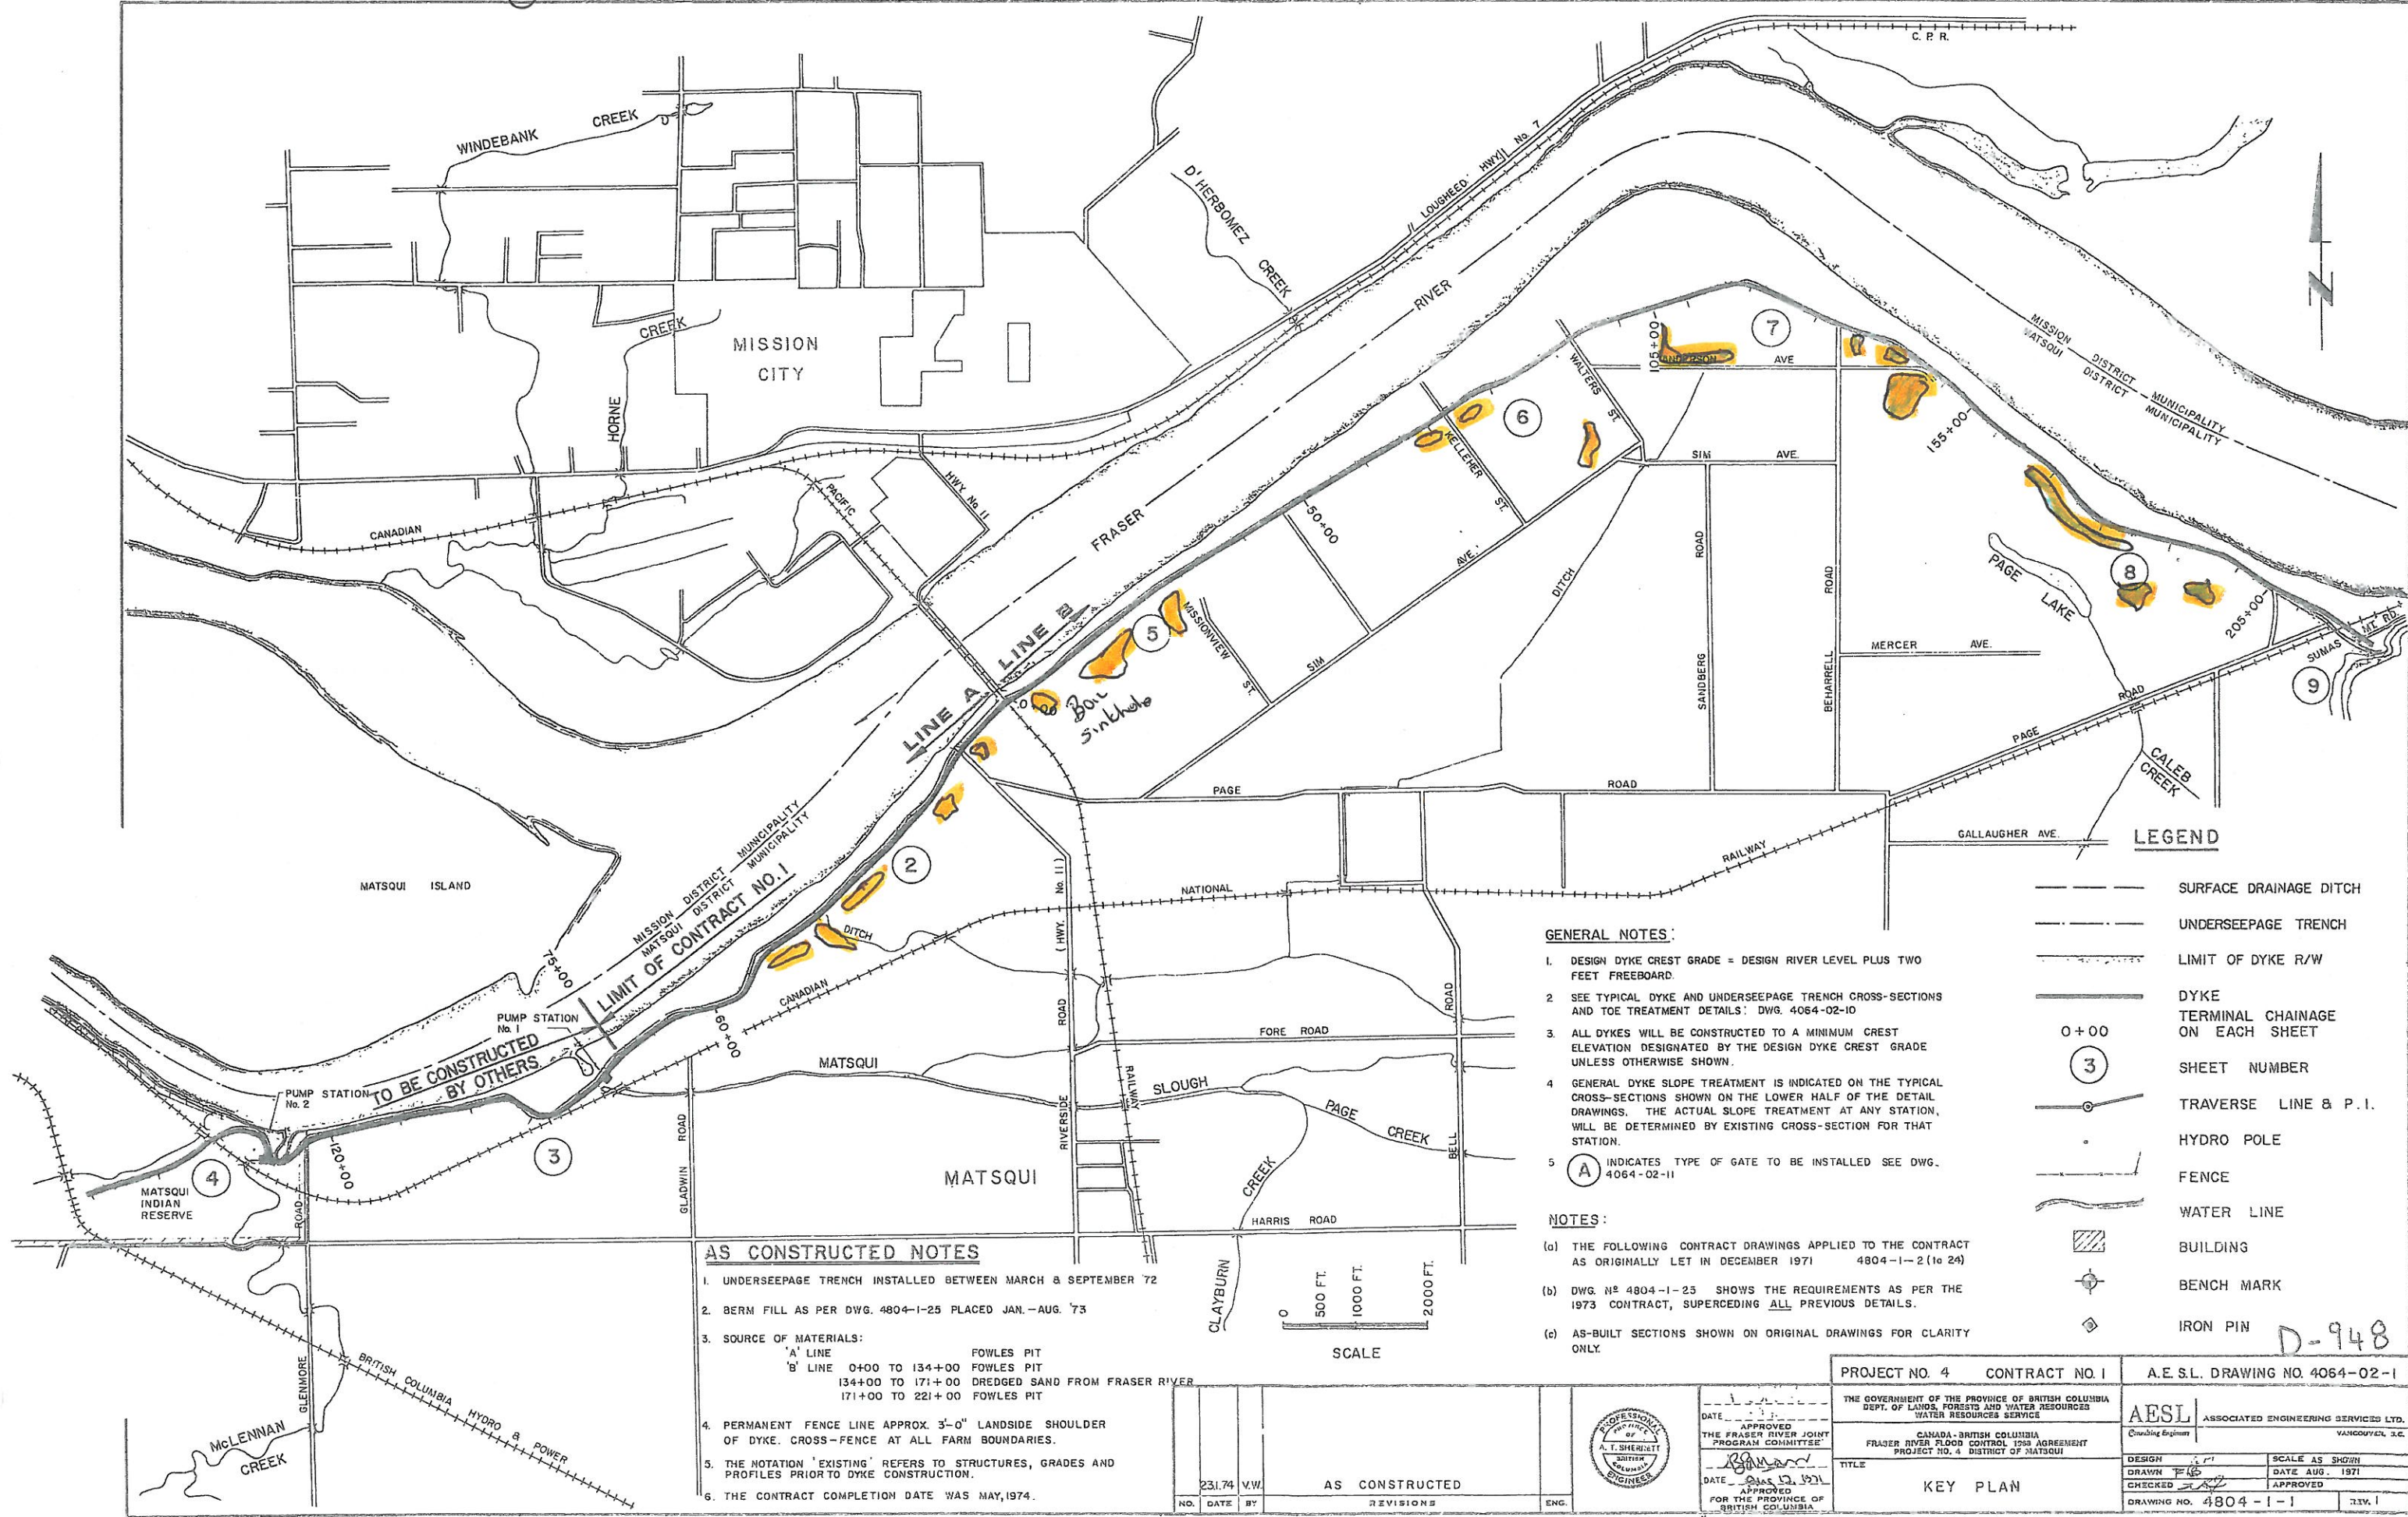

**AS CONSTRUCTED NOTES**

1. UNDERSEEPAGE TRENCH INSTALLED BETWEEN MARCH & SEPTEMBER 72
2. BERM FILL AS PER DWG. 4804-1-25 PLACED JAN.-AUG. 73
3. SOURCE OF MATERIALS:  
 'A' LINE FOWLES PIT  
 'B' LINE 0+00 TO 134+00 FOWLES PIT  
 134+00 TO 171+00 DREDGED SAND FROM FRASER RIVER  
 171+00 TO 221+00 FOWLES PIT
4. PERMANENT FENCE LINE APPROX. 3'-0" LANDSIDE SHOULDER OF DYKE. CROSS-FENCE AT ALL FARM BOUNDARIES.
5. THE NOTATION 'EXISTING' REFERS TO STRUCTURES, GRADES AND PROFILES PRIOR TO DYKE CONSTRUCTION.
6. THE CONTRACT COMPLETION DATE WAS MAY, 1974.

**GENERAL NOTES:**

1. DESIGN DYKE CREST GRADE = DESIGN RIVER LEVEL PLUS TWO FEET FREEBOARD.
2. SEE TYPICAL DYKE AND UNDERSEEPAGE TRENCH CROSS-SECTIONS AND TOE TREATMENT DETAILS: DWG. 4064-02-10
3. ALL DYKES WILL BE CONSTRUCTED TO A MINIMUM CREST ELEVATION DESIGNATED BY THE DESIGN DYKE CREST GRADE UNLESS OTHERWISE SHOWN.
4. GENERAL DYKE SLOPE TREATMENT IS INDICATED ON THE TYPICAL CROSS-SECTIONS SHOWN ON THE LOWER HALF OF THE DETAIL DRAWINGS. THE ACTUAL SLOPE TREATMENT AT ANY STATION, WILL BE DETERMINED BY EXISTING CROSS-SECTION FOR THAT STATION.
5. (A) INDICATES TYPE OF GATE TO BE INSTALLED SEE DWG. 4064-02-11


**NOTES:**

- (a) THE FOLLOWING CONTRACT DRAWINGS APPLIED TO THE CONTRACT AS ORIGINALLY LET IN DECEMBER 1971 4804-1-2 (1 to 24)
- (b) DWG. N° 4804-1-25 SHOWS THE REQUIREMENTS AS PER THE 1973 CONTRACT, SUPERCEDING ALL PREVIOUS DETAILS.
- (c) AS-BUILT SECTIONS SHOWN ON ORIGINAL DRAWINGS FOR CLARITY ONLY.

**LEGEND**

	SURFACE DRAINAGE DITCH
	UNDERSEEPAGE TRENCH
	LIMIT OF DYKE R/W
	DYKE
	TERMINAL CHAINAGE ON EACH SHEET
0+00	
(3)	SHEET NUMBER
	TRAVERSE LINE & P.I.
	HYDRO POLE
	FENCE
	WATER LINE
	BUILDING
	BENCH MARK
	IRON PIN

NO.	DATE	BY	REVISIONS	ENG.
231.74	V.V.		AS CONSTRUCTED	

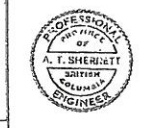

DATE: 12/1/71  
 APPROVED  
 THE FRASER RIVER JOINT PROGRAM COMMITTEE  
 DATE: 12/1/71  
 APPROVED  
 FOR THE PROVINCE OF BRITISH COLUMBIA

PROJECT NO. 4	CONTRACT NO. 1	A.E.S.L. DRAWING NO. 4064-02-1
THE GOVERNMENT OF THE PROVINCE OF BRITISH COLUMBIA DEPT. OF LANDS, FORESTS AND WATER RESOURCES WATER RESOURCES SERVICE		
CANADA-BRITISH COLUMBIA FRASER RIVER FLOOD CONTROL 1968 AGREEMENT PROJECT NO. 4 DISTRICT OF MATSQUI		
TITLE KEY PLAN		SCALE AS SHOWN DATE AUG. 1971 CHECKED [Signature] APPROVED [Signature]
DRAWING NO. 4804-1-1	REV. 1	