


2021 Freshet Seepage

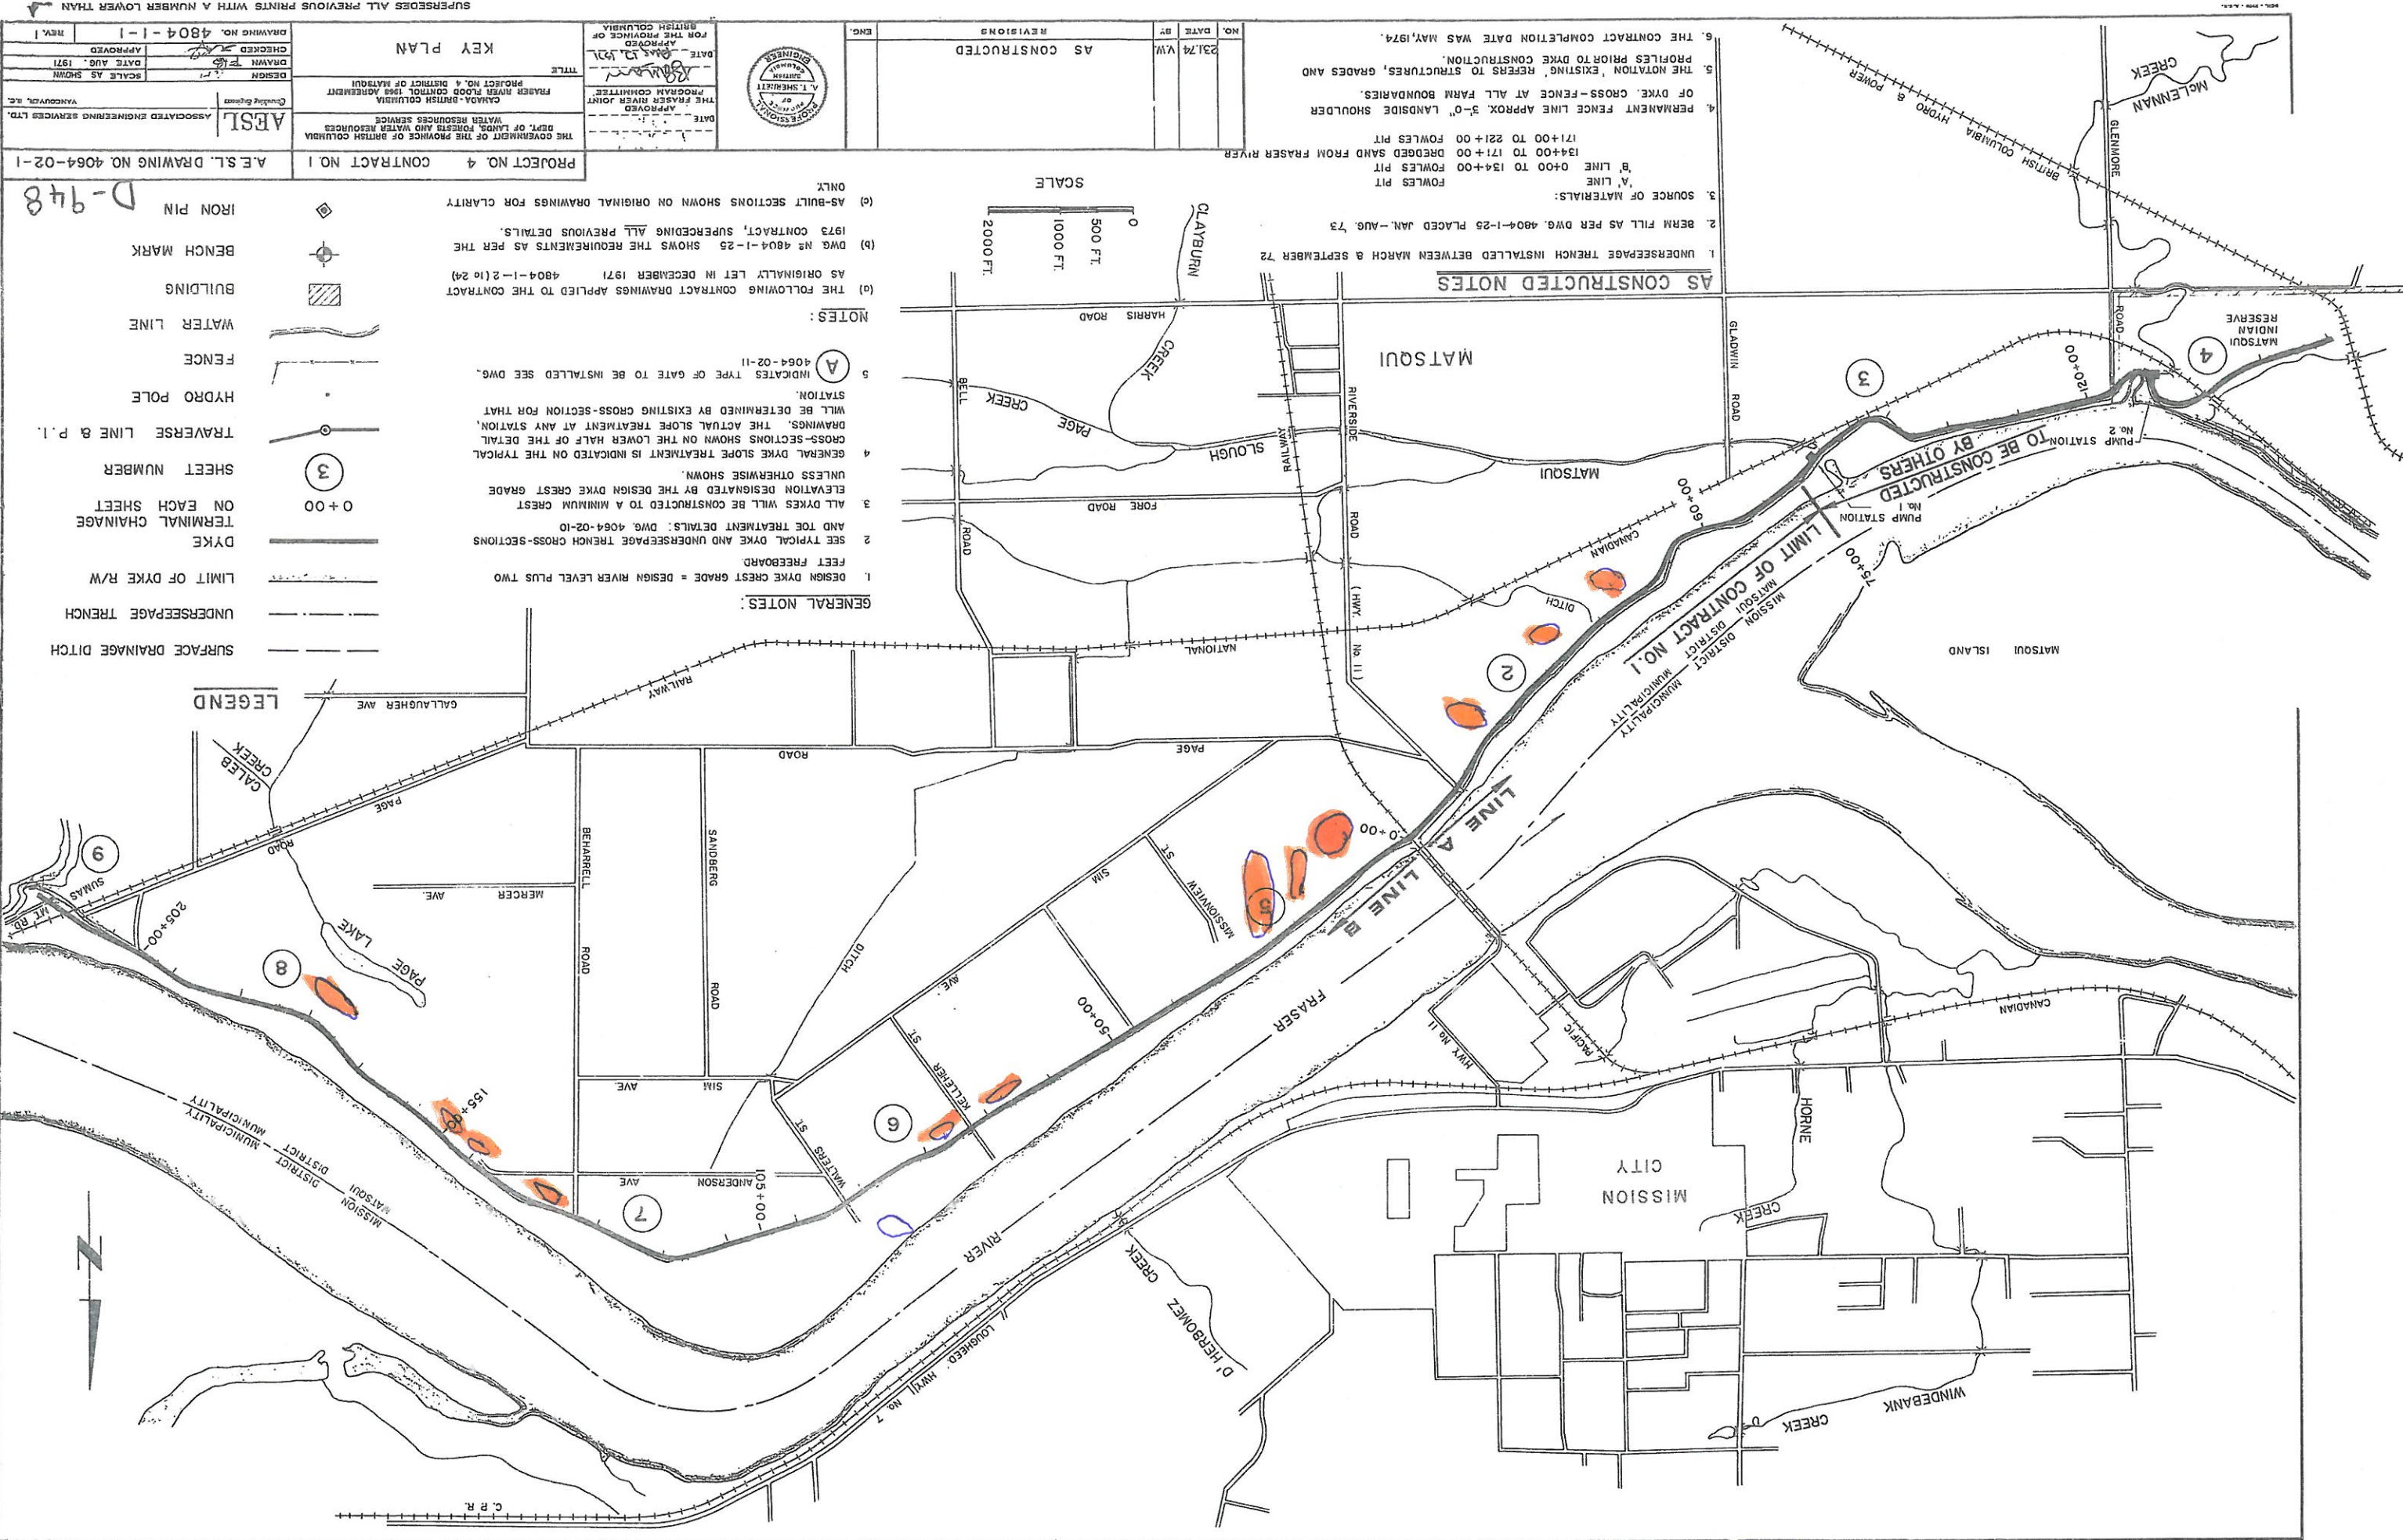


- LEGEND**
- SURFACE DRAINAGE DITCH
 - - - UNDERSEEPAGE TRENCH
 - LIMIT OF DYKE R/W
 - DYKE
 - TERMINAL CHAINAGE ON EACH SHEET
 - 3 — SHEET NUMBER
 - TRAVERSE LINE & P.I.
 - HYDRO POLE
 - FENCE
 - WATER LINE
 - BUILDING
 - BENCH MARK
 - IRON PIN

GENERAL NOTES:

- DESIGN DYKE CREST GRADE = DESIGN RIVER LEVEL PLUS TWO FEET FREEBOARD
- SEE TYPICAL DYKE AND UNDERSEEPAGE TRENCH CROSS-SECTIONS AND TOE TREATMENT DETAILS: DWG. 4064-02-10
- ALL DYKES WILL BE CONSTRUCTED TO A MINIMUM CREST ELEVATION DESIGNATED BY THE DESIGN DYKE CREST GRADE UNLESS OTHERWISE SHOWN.
- GENERAL DYKE SLOPE TREATMENT IS INDICATED ON THE TYPICAL CROSS-SECTIONS SHOWN ON THE LOWER HALF OF THE DETAIL DRAWINGS. THE ACTUAL SLOPE TREATMENT AT ANY STATION WILL BE DETERMINED BY EXISTING CROSS-SECTION FOR THAT STATION.
- (A) INDICATES TYPE OF GATE TO BE INSTALLED SEE DWG. 4064-02-11

NOTES:

- THE FOLLOWING CONTRACT DRAWINGS APPLIED TO THE CONTRACT 4064-1-2(1 to 24)
- DWG. NO. 4064-1-25 SHOWS THE REQUIREMENTS AS PER THE 1973 CONTRACT, SUPERSEDING ALL PREVIOUS DETAILS.
- AS-BUILT SECTIONS SHOWN ON ORIGINAL DRAWINGS FOR CLARITY ONLY

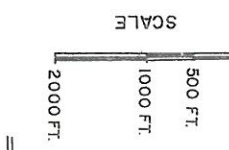

AS CONSTRUCTED NOTES

- UNDERSEEPAGE TRENCH INSTALLED BETWEEN MARCH & SEPTEMBER 72
- BERM FILL AS PER DWG. 4064-1-25 PLACED JAN. - AUG. 73
- SOURCE OF MATERIALS:
 'A' LINE
 FOWLES PIT
 0+00 TO 134+00 FOWLES PIT
 134+00 TO 171+00 FOWLES PIT
 171+00 TO 221+00 FOWLES PIT
- PERMANENT FENCE LINE APPROX. 5'-0" LANDSIDE SHOULDER OF DYKE. CROSS-FENCE AT ALL FARM BOUNDARIES.
- THE NOTATION 'EXISTING' REFERS TO STRUCTURES, GRADES AND PROFILES PRIOR TO DYKE CONSTRUCTION.
- THE CONTRACT COMPLETION DATE WAS MAY, 1974.

PROJECT NO. 4 CONTRACT NO. 1		A.E.S.L. DRAWING NO. 4064-02-1	
THE GOVERNMENT OF BRITISH COLUMBIA DEPT. OF LANDS, FORESTS AND WATER RESOURCES WATER RESOURCES SERVICE		DESIGN: A.E.S.L. ASSOCIATED ENGINEERING SERVICES LTD. VANCOUVER, B.C.	
APPROVED FOR THE FRASER RIVER JOINT PROGRAM COMMITTEE		DATE: 12/1/73	
APPROVED FOR THE PROVINCE OF BRITISH COLUMBIA		DATE: 12/1/73	
TITLE: FRASER RIVER FLOOD CONTROL 1969 AGREEMENT PROJECT NO. 4 DISTRICT OF MATSQUI		KEY PLAN	
DESIGN: A.E.S.L.	CHECKED: [Signature]	DRAWN: [Signature]	DATE: AUG. 1971
SCALE AS SHOWN	APPROVED: [Signature]	DRAWING NO. 4804-1-1	REV. 1

SUPERSEDES ALL PREVIOUS PRINTS WITH A NUMBER LOWER THAN